


### REVISIONS

#	DATE	ITEM
No 5		
No 4		
No 3		
No 2		
No 1		

ORB 17098 PAGE 1602

ORB 17098 PAGE 1602

ORB 12029 PAGE 1477

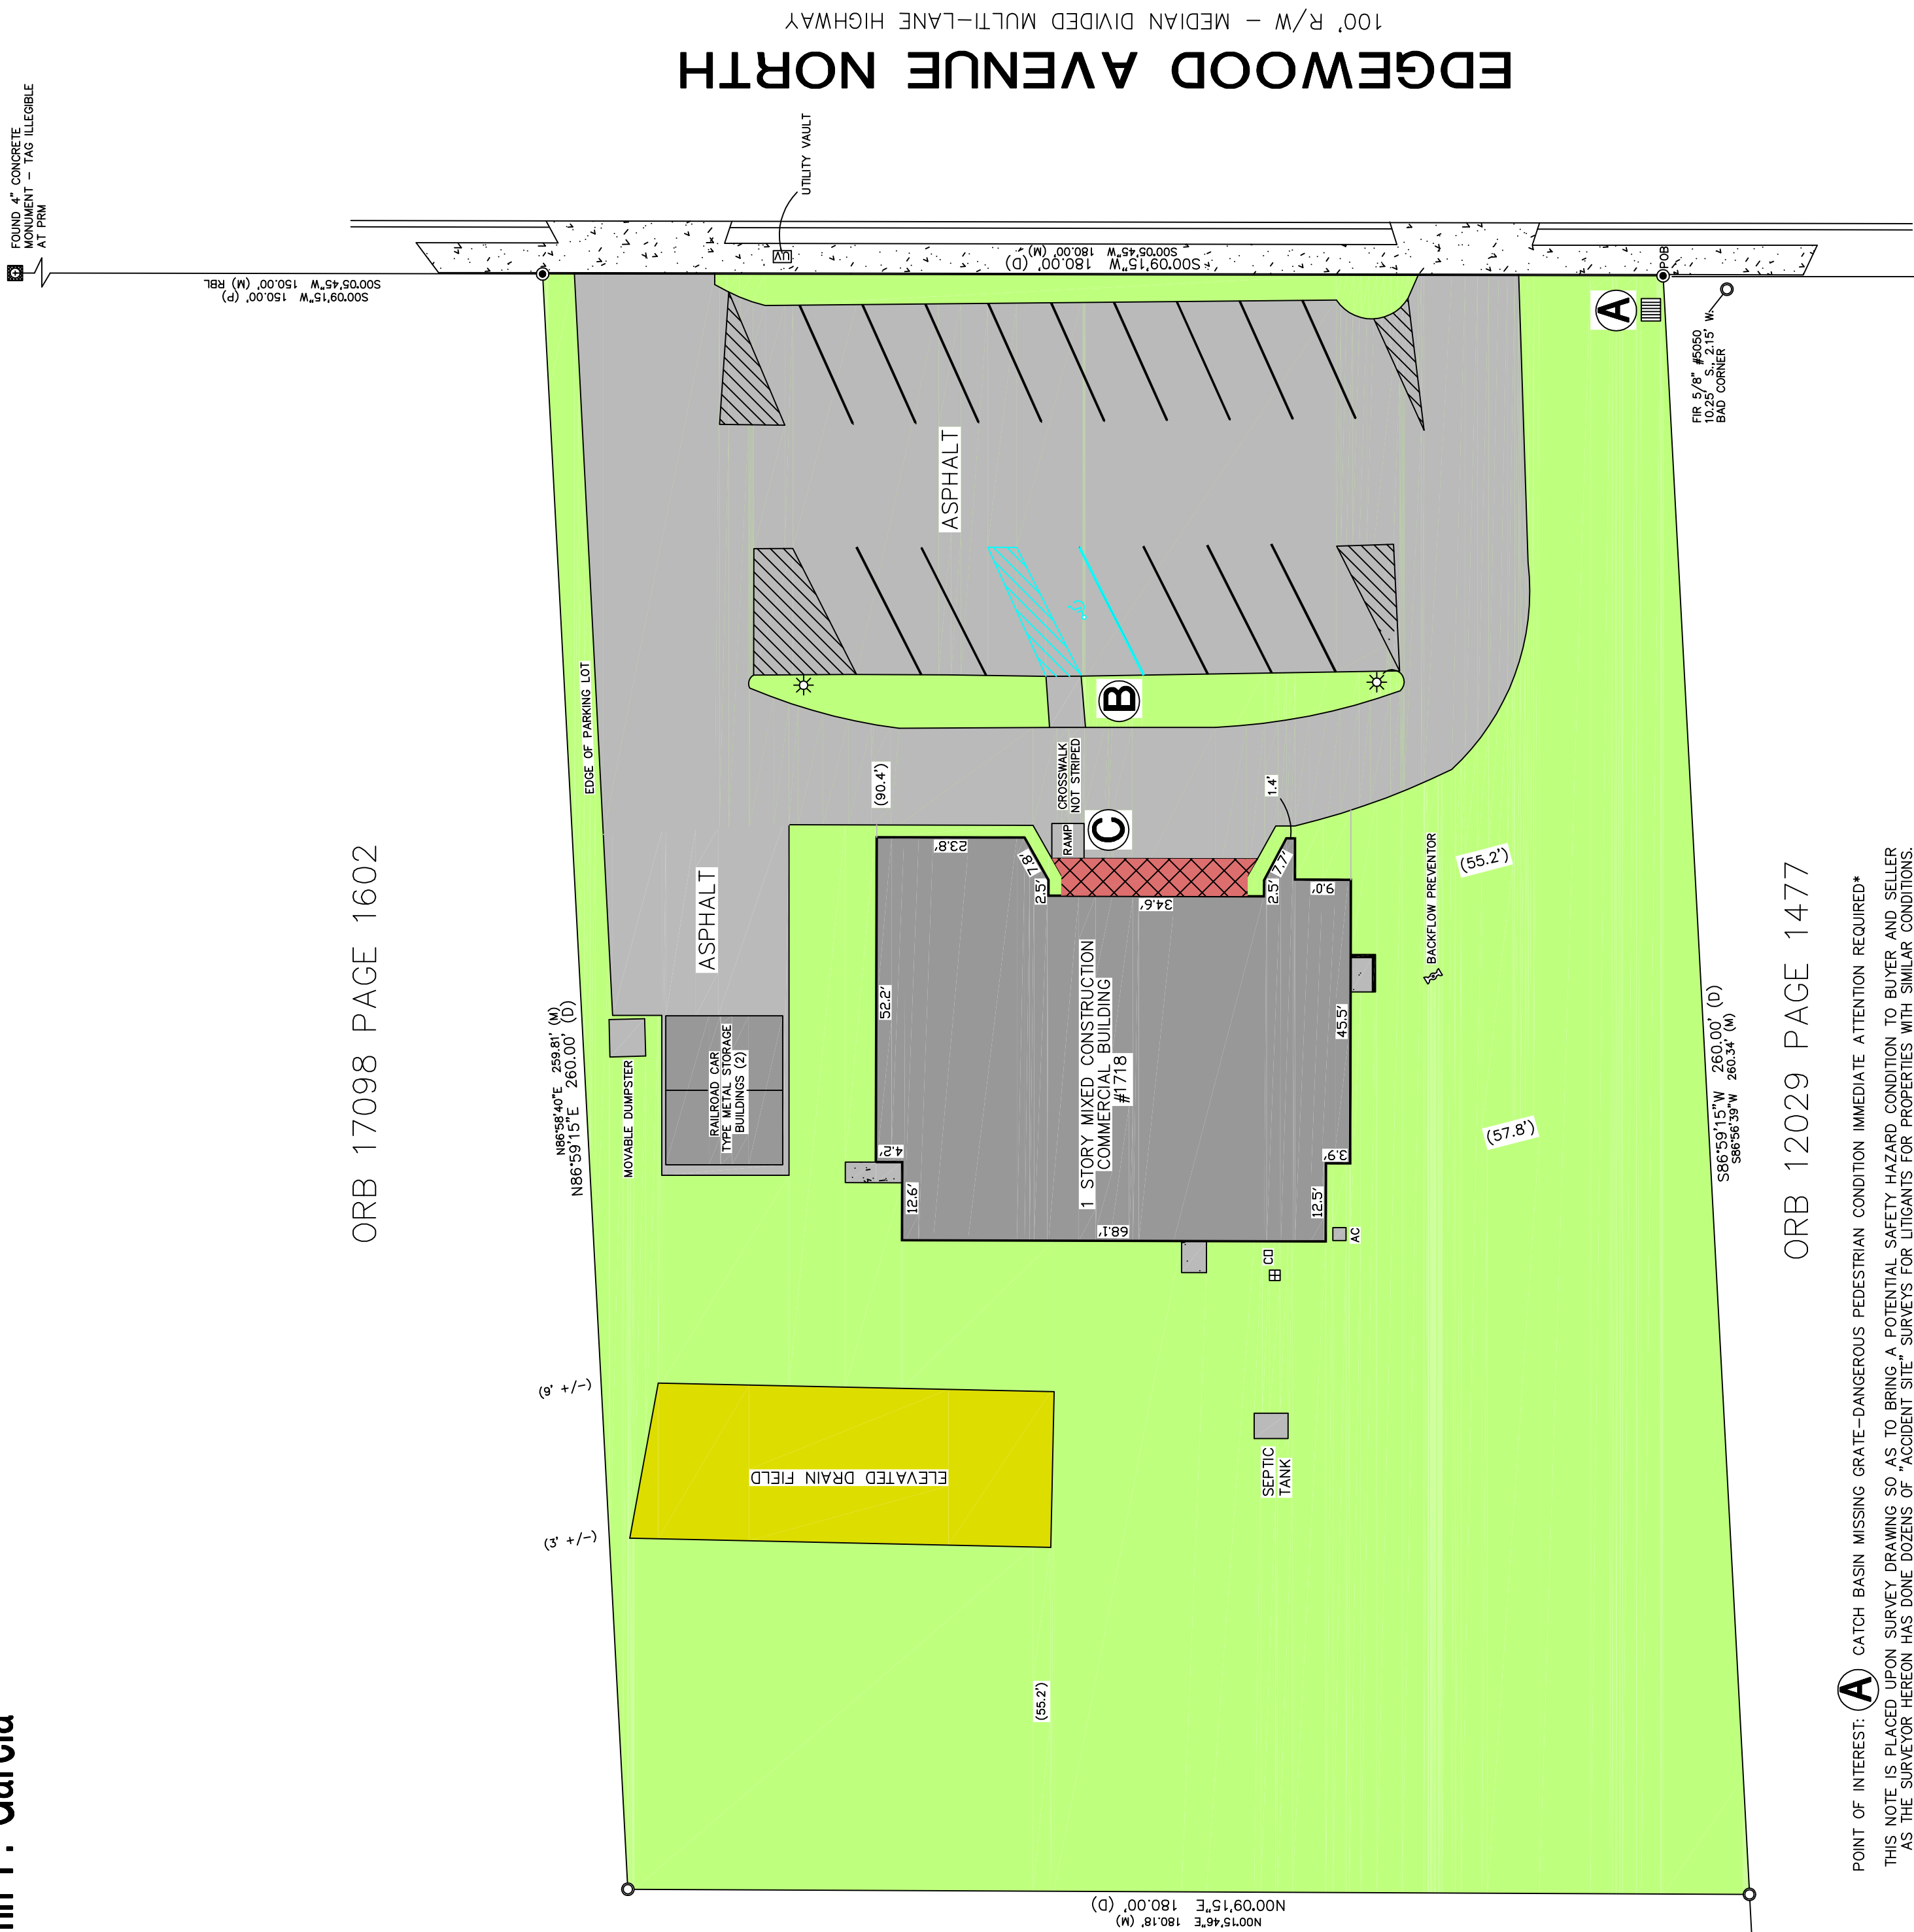

### LEGAL DESCRIPTION

THE SOUTHERLY 180 FEET OF THE EASTERLY 260 FEET OF ACREAGE REPLAT OF EDGEWOOD TERRACE AS SHOWN ON THE PLAT RECORDED IN PLAT BOOK 38, PAGES 100 AND 100A OF THE CURRENT PUBLIC RECORDS OF DUVAL COUNTY, FLORIDA, BEING MORE PARTICULARLY DESCRIBED AS FOLLOWS:


FOR A POINT OF BEGINNING, COMMENCE AT THE SOUTHEAST CORNER OF SAID ACREAGE REPLAT OF EDGEWOOD TERRACE AND RUN S86°59'15"E A DISTANCE OF 260.00 FEET TO A POINT; RUN THENCE N00°09'15"E, A DISTANCE OF 180.00 FEET TO A POINT; RUN THENCE N86°59'15"E TO A POINT ON THE WESTERLY RIGHT-OF-WAY LINE OF EDGEWOOD AVENUE ( A 100 FOOT RIGHT-OF-WAY ); RUN THENCE S00°09'15"W, ALONG SAID WESTERLY RIGHT-OF-WAY LINE, A DISTANCE OF 180.00 FEET TO THE POINT OF BEGINNING.

CONTAINING 1.07 ACRES, MORE OR LESS


### SURVEYOR'S NOTES:

- Legal Description has been furnished by client and/or his/her agents.
- No Title Opinion or Abstract of Matters Affecting the Title of Boundary of this Survey has been provided by the client. The surveyor has reviewed the recorded plat and other instruments that could affect this property that a current title commitment would show.
- Measurements hereon are in accordance with U.S. Standard Feet, data acquired with theodolite and steel tape, or with Technologically Superior Equipment utilizing Redundant Techniques.
- Bearings hereon are based on: MONUMENTED FRONT PROPERTY LINE/RIGHT-OF-WAY LINE AS SHOWN ON THE PLAT.
- Contiguous lots lie in some block, unit, phase, section etc. unless noted.
- Type of Survey: FLORIDA BOUNDARY.
- Stated Legal Purpose of Survey: Acquisition (See Mortgage/Venue/Planning).
- According to information from MDC.FDA.GOV (Internet) this property currently lies in Flood Zone X.
- This Survey is not intended to locate any subsurface/underground objects, improvements, foundations or encroachments. Survey reflects above-ground features and improvements only.
- This Survey Does NOT Reflect or Determine Ownership.
- This Survey is NOT Insured for Multiple Uses. Factory and all other obligations are limited to Certificates listed hereon utilizing Survey for purposes listed in Item 7 Above. See Note Above Signature Block.
- Construct Improvements to Iron Markers as Described Only. Wooden Stakes are NOT Property Corners.
- See Note #9 above - no efforts have been made or requested to locate underground utilities.
- All boundary dimensions shown hereon are field measured and are in agreement with the Plot and/or Deed Legal Description unless noted otherwise on the face of this drawing.
- Street (s) hereon are centered in R/W unless noted.
- Building Dimensions and their ties to adjacent property or other lines are made from exterior load-bearing walls, ignoring overhangs and eave/curly attachments unless noted. Ties to structures are made by perpendicular measurement from nearest property or other line.
- The Linear Closure of this survey exceeds 1:10,000.
- Elevations-if shown-are based on the North American Vertical Datum-of-1988. Fences and other features relationship to adjacent property line (highest line on drawing) may be exaggerated slightly as to not be obscured by tick line. Dimensions listed shall override graphic depiction in all cases.
- This is MADE an ALTA/ACSL Survey, See Note # 6 above.

MEASURED BEARINGS HEREON ARE BASED ON FLORIDA DEPARTMENT OF TRANSPORTATION BENCHMARKS "BART" AND "KREG", WHICH WERE DERIVED FROM A GLOBAL POSITIONING SYSTEM (GPS) REAL-TIME KINEMATIC (RTK) SURVEY. A SOKKIA GRX1 GPS RECEIVER WAS USED AS A ROVER; RTK CORRECTIONS WERE OBTAINED FROM THE FLORIDA PERMANENT REFERENCED NETWORK (FPRN). COORDINATES OBTAINED FROM THE GPS SURVEY ARE REFERENCE TO NORTH AMERICAN DATUM OF 1983 (NAD83)-(2011)-(EPOCH 2010.0000).

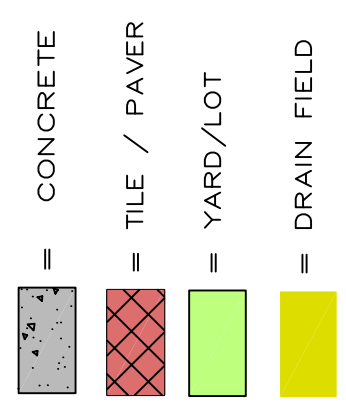

- POINT OF INTEREST: (A) CATCH BASIN MISSING GRATE-DANGEROUS PEDESTRIAN CONDITION IMMEDIATE ATTENTION REQUIRED\* THIS NOTE IS PLACED UPON SURVEY DRAWING SO AS TO BRING A POTENTIAL SAFETY HAZARD CONDITION TO BUYER AND SELLER AS THE SURVEYOR HEREON HAS DONE DOZENS OF "ACCIDENT SITE" SURVEYS FOR LITIGANTS FOR PROPERTIES WITH SIMILAR CONDITIONS. THE PUBLIC INCLUDES THE BUYER, SELLER AND ALL UNKNOWN THIRD PARTIES WHO MIGHT TRAVERSE THE PROPERTY FOR ANY AND ALL USES.
- POINT OF INTEREST: (B) DEDICATED HANDICAPPED PARKING SPACE DOES NOT MEET ADA REQUIREMENTS\* AMERICANS WITH DISABILITIES ACT (S) REQUIRE HANDICAPPED DESIGNATED SPACES TO BE 13.5' WIDE ( NON-CONFORMING 5' WIDE ) ADJACENT BUFFER IS TO BE 5' WIDE ( NON- CONFORMING AT 4' WIDE ) DESIGNATED BY SIGN ON POST- BOTTOM OF SIGN = 6.5 FROM GROUND (NON-CONFORMING AT 2.5 FROM GROUND)
- SURVEYOR'S SPECIAL NOTE: THERE IS AMPLE ROOM IN EXISTING TIER OF PARKING SPACES TO RE-STRIPE H.C. SPACE/BUFFER PROPERLY WHILE MAINTAINING CURRENT NUMBER OF SPACES.
- POINT OF INTEREST: (C) HANDICAP RAMP PAINTED YELLOW INSTEAD OF BLUE PAINT EXTENDS SOUTHERLY BEYOND ACTUAL RAMP.\*
- SURVEYOR'S SPECIAL NOTE: THE YELLOW PAINTED AREA AT HANDICAP RAMP EXTENDS BEYOND (TO SOUTH) OF ACTUAL RAMP. TO ROLL OR STEP OFF ONTO A 1/2 FOOT VERTICAL DROP WHICH COULD CAUSE INJURY. THE BUILDING THE YELLOW PAINT NEEDS TO BE REPLACED WITH BLUE PAINT TO CONFORM, AND SHOULD BE A CONFORMING SAFEGUARD TO HELP ASSURE NO LAWSUITS BY INADVERTANT INJURY.
- THIS NOTE IS PLACED UPON SURVEY DRAWING SO AS TO BRING A POTENTIAL SAFETY HAZARD CONDITION TO BUYER AND SELLER AS THE SURVEYOR HEREON HAS DONE DOZENS OF "ACCIDENT SITE" SURVEYS FOR LITIGANTS FOR PROPERTIES WITH SIMILAR CONDITIONS. THE PUBLIC INCLUDES THE BUYER, SELLER AND ALL UNKNOWN THIRD PARTIES WHO MIGHT TRAVERSE THE PROPERTY FOR ANY AND ALL USES.

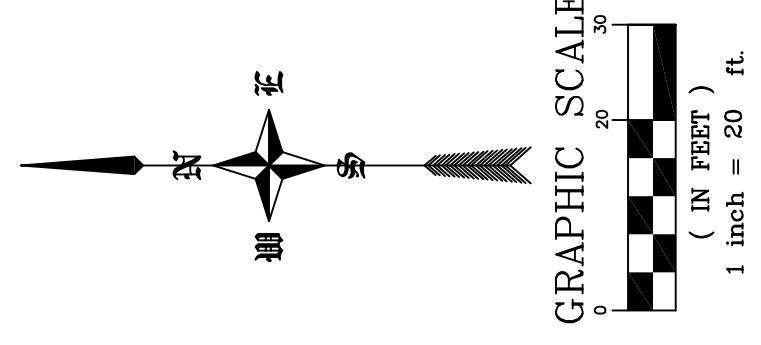

November 23, 2019  
Exhibit 4  
Page 1 of 1

### Special Note - Liability Notice

NOTICE: THIS SURVEY IS CERTAINLY NOT INTENDED TO BE A GUARANTEE OF TITLE AND CERTIFICATION BUDS BELOW ANY OTHER USE. BUYER OR RELIANCE BY ANY OTHER PARTY IS STRICTLY PROHIBITED AND RESTRICTED. SURVEYOR IS RESPONSIBLE ONLY TO THOSE CERTIFIED AND HEREBY DISCLAIMS ANY OTHER LIABILITY AND HEREBY RESTRICTS LIABILITY TO THE EXTENT PERMITTED BY FLORIDA STATUTES. WITHOUT THE WRITTEN CONSENT OF Timothy L. Blackmon, PSM. SEE SURVEYOR'S NOTE #11 HEREON.

### Surveyor's Certification

Reproductions of this Sketch of Survey are not valid unless sealed with my embossed seal #4880 Florida THE SKETCH OF SURVEY DEPICTED HEREON CONFORMS TO THE STANDARDS OF PRACTICE SET FORTH BY THE FLORIDA SURVEYING BOARD AND THE FLORIDA STATUTES AND WAS DONE UNDER MY SUPERVISION.

Signature Date  
11/25/2019  
Copyright  
Do not copy or reproduce without permission.

### LEGEND & ABBREVIATIONS

AC = Acres in G	AD = Adjacent	BL = Boundary Line	BR = Boundary Reference Monument	CH = Chain Link Fence	CI = Contour Interval	CO = Contour	CR = Corner	CS = Corner Stake	CU = Corner Utility	DA = Ditch	DE = Deed	DI = Ditch	DR = Drain	EA = Edge of Asphalt	EB = Edge of Building	EC = Edge of Concrete	ED = Edge of Driveway	EE = Edge of Easement	EF = Edge of Fence	EG = Edge of Gravel	EH = Edge of Hardscape	EI = Edge of Iron	EJ = Edge of Joint	EK = Edge of Kerf	EL = Edge of Ledge	EM = Easement	EN = Edge of Niche	EO = Edge of Eave	EP = Edge of Porch	EQ = Edge of Quarry	ER = Edge of Road	ES = Edge of Sidewalk	ET = Edge of Terrace	EU = Edge of Utility	EV = Edge of Vault	EW = Edge of Wall	EX = Edge of Excavation	EY = Edge of Yard	EZ = Edge of Zone	FA = Face of Asphalt	FB = Face of Building	FC = Face of Concrete	FD = Face of Driveway	FE = Face of Easement	FF = Face of Fence	FG = Face of Gravel	FH = Face of Hardscape	FI = Face of Iron	FJ = Face of Joint	FK = Face of Kerf	FL = Face of Ledge	FM = Face of Masonry	FN = Face of Niche	FO = Face of Foundation	FP = Face of Footing	FQ = Face of Foundation	FR = Face of Road	FS = Face of Sidewalk	FT = Face of Terrace	FU = Face of Utility	FV = Face of Vault	FW = Face of Wall	FX = Face of Excavation	FY = Face of Yard	FZ = Face of Zone	GA = Grade of Asphalt	GB = Grade of Building	GC = Grade of Concrete	GD = Grade of Driveway	GE = Grade of Easement	GF = Grade of Fence	GG = Grade of Gravel	GH = Grade of Hardscape	GI = Grade of Iron	GJ = Grade of Joint	GK = Grade of Kerf	GL = Grade of Ledge	GM = Grade of Masonry	GN = Grade of Niche	GO = Grade of Foundation	GP = Grade of Footing	GQ = Grade of Foundation	GR = Grade of Road	GS = Grade of Sidewalk	GT = Grade of Terrace	GU = Grade of Utility	GV = Grade of Vault	GW = Grade of Wall	GX = Grade of Excavation	GY = Grade of Yard	GZ = Grade of Zone	HA = Height of Asphalt	HB = Height of Building	HC = Height of Concrete	HD = Height of Driveway	HE = Height of Easement	HF = Height of Fence	HG = Height of Gravel	HH = Height of Hardscape	HI = Height of Iron	HJ = Height of Joint	HK = Height of Kerf	HL = Height of Ledge	HM = Height of Masonry	HN = Height of Niche	HO = Height of Foundation	HP = Height of Footing	HQ = Height of Foundation	HR = Height of Road	HS = Height of Sidewalk	HT = Height of Terrace	HU = Height of Utility	HV = Height of Vault	HW = Height of Wall	HX = Height of Excavation	HY = Height of Yard	HZ = Height of Zone	IA = Inside of Asphalt	IB = Inside of Building	IC = Inside of Concrete	ID = Inside of Driveway	IE = Inside of Easement	IF = Inside of Fence	IG = Inside of Gravel	IH = Inside of Hardscape	II = Inside of Iron	IJ = Inside of Joint	IK = Inside of Kerf	IL = Inside of Ledge	IM = Inside of Masonry	IN = Inside of Niche	IO = Inside of Foundation	IP = Inside of Footing	IQ = Inside of Foundation	IR = Inside of Road	IS = Inside of Sidewalk	IT = Inside of Terrace	IU = Inside of Utility	IV = Inside of Vault	IW = Inside of Wall	IX = Inside of Excavation	IY = Inside of Yard	IZ = Inside of Zone	JA = Junction of Asphalt	JB = Junction of Building	JC = Junction of Concrete	JD = Junction of Driveway	JE = Junction of Easement	JF = Junction of Fence	JG = Junction of Gravel	JH = Junction of Hardscape	JI = Junction of Iron	JJ = Junction of Joint	JK = Junction of Kerf	JL = Junction of Ledge	JM = Junction of Masonry	JN = Junction of Niche	JO = Junction of Foundation	JP = Junction of Footing	JQ = Junction of Foundation	JR = Junction of Road	JS = Junction of Sidewalk	JT = Junction of Terrace	JU = Junction of Utility	JV = Junction of Vault	JW = Junction of Wall	JX = Junction of Excavation	JY = Junction of Yard	JZ = Junction of Zone	KA = Kerf of Asphalt	KB = Kerf of Building	KC = Kerf of Concrete	KD = Kerf of Driveway	KE = Kerf of Easement	KF = Kerf of Fence	KG = Kerf of Gravel	KH = Kerf of Hardscape	KI = Kerf of Iron	KJ = Kerf of Joint	KK = Kerf of Kerf	KL = Kerf of Ledge	KM = Kerf of Masonry	KN = Kerf of Niche	KO = Kerf of Foundation	KP = Kerf of Footing	KQ = Kerf of Foundation	KR = Kerf of Road	KS = Kerf of Sidewalk	KT = Kerf of Terrace	KU = Kerf of Utility	KV = Kerf of Vault	KW = Kerf of Wall	KX = Kerf of Excavation	KY = Kerf of Yard	KZ = Kerf of Zone	LA = Length of Asphalt	LB = Length of Building	LC = Length of Concrete	LD = Length of Driveway	LE = Length of Easement	LF = Length of Fence	LG = Length of Gravel	LH = Length of Hardscape	LI = Length of Iron	LJ = Length of Joint	LK = Length of Kerf	LL = Length of Ledge	LM = Length of Masonry	LN = Length of Niche	LO = Length of Foundation	LP = Length of Footing	LQ = Length of Foundation	LR = Length of Road	LS = Length of Sidewalk	LT = Length of Terrace	LU = Length of Utility	LV = Length of Vault	LW = Length of Wall	LX = Length of Excavation	LY = Length of Yard	LZ = Length of Zone	MA = Material of Asphalt	MB = Material of Building	MC = Material of Concrete	MD = Material of Driveway	ME = Material of Easement	MF = Material of Fence	MG = Material of Gravel	MH = Material of Hardscape	MI = Material of Iron	MJ = Material of Joint	MK = Material of Kerf	ML = Material of Ledge	MM = Material of Masonry	MN = Material of Niche	MO = Material of Foundation	MP = Material of Footing	MQ = Material of Foundation	MR = Material of Road	MS = Material of Sidewalk	MT = Material of Terrace	MU = Material of Utility	MV = Material of Vault	MW = Material of Wall	MX = Material of Excavation	MY = Material of Yard	MZ = Material of Zone	NA = Name of Asphalt	NB = Name of Building	NC = Name of Concrete	ND = Name of Driveway	NE = Name of Easement	NF = Name of Fence	NG = Name of Gravel	NH = Name of Hardscape	NI = Name of Iron	NJ = Name of Joint	NK = Name of Kerf	NL = Name of Ledge	NM = Name of Masonry	NN = Name of Niche	NO = Name of Foundation	NP = Name of Footing	NQ = Name of Foundation	NR = Name of Road	NS = Name of Sidewalk	NT = Name of Terrace	NU = Name of Utility	NV = Name of Vault	NW = Name of Wall	NX = Name of Excavation	NY = Name of Yard	NZ = Name of Zone	OA = Orientation of Asphalt	OB = Orientation of Building	OC = Orientation of Concrete	OD = Orientation of Driveway	OE = Orientation of Easement	OF = Orientation of Fence	OG = Orientation of Gravel	OH = Orientation of Hardscape	OI = Orientation of Iron	OJ = Orientation of Joint	OK = Orientation of Kerf	OL = Orientation of Ledge	OM = Orientation of Masonry	ON = Orientation of Niche	OO = Orientation of Foundation	OP = Orientation of Footing	OQ = Orientation of Foundation	OR = Orientation of Road	OS = Orientation of Sidewalk	OT = Orientation of Terrace	OU = Orientation of Utility	OV = Orientation of Vault	OW = Orientation of Wall	OX = Orientation of Excavation	OY = Orientation of Yard	OZ = Orientation of Zone	PA = Position of Asphalt	PB = Position of Building	PC = Position of Concrete	PD = Position of Driveway	PE = Position of Easement	PF = Position of Fence	PG = Position of Gravel	PH = Position of Hardscape	PI = Position of Iron	PJ = Position of Joint	PK = Position of Kerf	PL = Position of Ledge	PM = Position of Masonry	PN = Position of Niche	PO = Position of Foundation	PP = Position of Footing	PQ = Position of Foundation	PR = Position of Road	PS = Position of Sidewalk	PT = Position of Terrace	PU = Position of Utility	PV = Position of Vault	PW = Position of Wall	PX = Position of Excavation	PY = Position of Yard	PZ = Position of Zone	QA = Quantity of Asphalt	QB = Quantity of Building	QC = Quantity of Concrete	QD = Quantity of Driveway	QE = Quantity of Easement	QF = Quantity of Fence	QG = Quantity of Gravel	QH = Quantity of Hardscape	QI = Quantity of Iron	QJ = Quantity of Joint	QK = Quantity of Kerf	QL = Quantity of Ledge	QM = Quantity of Masonry	QN = Quantity of Niche	QO = Quantity of Foundation	QP = Quantity of Footing	QQ = Quantity of Foundation	QR = Quantity of Road	QS = Quantity of Sidewalk	QT = Quantity of Terrace	QU = Quantity of Utility	QV = Quantity of Vault	QW = Quantity of Wall	QX = Quantity of Excavation	QY = Quantity of Yard	QZ = Quantity of Zone	RA = Radius of Asphalt	RB = Radius of Building	RC = Radius of Concrete	RD = Radius of Driveway	RE = Radius of Easement	RF = Radius of Fence	RG = Radius of Gravel	RH = Radius of Hardscape	RI = Radius of Iron	RJ = Radius of Joint	RK = Radius of Kerf	RL = Radius of Ledge	RM = Radius of Masonry	RN = Radius of Niche	RO = Radius of Foundation	RP = Radius of Footing	RQ = Radius of Foundation	RR = Radius of Road	RS = Radius of Sidewalk	RT = Radius of Terrace	RU = Radius of Utility	RV = Radius of Vault	RW = Radius of Wall	RX = Radius of Excavation	RY = Radius of Yard	RZ = Radius of Zone	SA = Slope of Asphalt	SB = Slope of Building	SC = Slope of Concrete	SD = Slope of Driveway	SE = Slope of Easement	SF = Slope of Fence	SG = Slope of Gravel	SH = Slope of Hardscape	SI = Slope of Iron	SJ = Slope of Joint	SK = Slope of Kerf	SL = Slope of Ledge	SM = Slope of Masonry	SN = Slope of Niche	SO = Slope of Foundation	SP = Slope of Footing	SQ = Slope of Foundation	SR = Slope of Road	SS = Slope of Sidewalk	ST = Slope of Terrace	SU = Slope of Utility	SV = Slope of Vault	SW = Slope of Wall	SX = Slope of Excavation	SY = Slope of Yard	SZ = Slope of Zone	TA = Thickness of Asphalt	TB = Thickness of Building	TC = Thickness of Concrete	TD = Thickness of Driveway	TE = Thickness of Easement	TF = Thickness of Fence	TG = Thickness of Gravel	TH = Thickness of Hardscape	TI = Thickness of Iron	TJ = Thickness of Joint	TK = Thickness of Kerf	TL = Thickness of Ledge	TM = Thickness of Masonry	TN = Thickness of Niche	TO = Thickness of Foundation	TP = Thickness of Footing	TQ = Thickness of Foundation	TR = Thickness of Road	TS = Thickness of Sidewalk	TT = Thickness of Terrace	TU = Thickness of Utility	TV = Thickness of Vault	TW = Thickness of Wall	TX = Thickness of Excavation	TY = Thickness of Yard	TZ = Thickness of Zone	UA = Unit of Asphalt	UB = Unit of Building	UC = Unit of Concrete	UD = Unit of Driveway	UE = Unit of Easement	UF = Unit of Fence	UG = Unit of Gravel	UH = Unit of Hardscape	UI = Unit of Iron	UJ = Unit of Joint	UK = Unit of Kerf	UL = Unit of Ledge	UM = Unit of Masonry	UN = Unit of Niche	UO = Unit of Foundation	UP = Unit of Footing	UQ = Unit of Foundation	UR = Unit of Road	US = Unit of Sidewalk	UT = Unit of Terrace	UU = Unit of Utility	UV = Unit of Vault	UW = Unit of Wall	UX = Unit of Excavation	UY = Unit of Yard	UZ = Unit of Zone	VA = Volume of Asphalt	VB = Volume of Building	VC = Volume of Concrete	VD = Volume of Driveway	VE = Volume of Easement	VF = Volume of Fence	VG = Volume of Gravel	VH = Volume of Hardscape	VI = Volume of Iron	VJ = Volume of Joint	VK = Volume of Kerf	VL = Volume of Ledge	VM = Volume of Masonry	VN = Volume of Niche	VO = Volume of Foundation	VP = Volume of Footing	VQ = Volume of Foundation	VR = Volume of Road	VS = Volume of Sidewalk	VT = Volume of Terrace	VU = Volume of Utility	VV = Volume of Vault	VW = Volume of Wall	VX = Volume of Excavation	VY = Volume of Yard	VZ = Volume of Zone	WA = Width of Asphalt	WB = Width of Building	WC = Width of Concrete	WD = Width of Driveway	WE = Width of Easement	WF = Width of Fence	WG = Width of Gravel	WH = Width of Hardscape	WI = Width of Iron	WJ = Width of Joint	WK = Width of Kerf	WL = Width of Ledge	WM = Width of Masonry	WN = Width of Niche	WO = Width of Foundation	WP = Width of Footing	WQ = Width of Foundation	WR = Width of Road	WS = Width of Sidewalk	WT = Width of Terrace	WU = Width of Utility	WV = Width of Vault	WW = Width of Wall	WX = Width of Excavation	WY = Width of Yard	WZ = Width of Zone	XA = X-axis of Asphalt	XB = X-axis of Building	XC = X-axis of Concrete	XD = X-axis of Driveway	XE = X-axis of Easement	XF = X-axis of Fence	XG = X-axis of Gravel	XH = X-axis of Hardscape	XI = X-axis of Iron	XJ = X-axis of Joint	XK = X-axis of Kerf	XL = X-axis of Ledge	XM = X-axis of Masonry	XN = X-axis of Niche	XO = X-axis of Foundation	XP = X-axis of Footing	XQ = X-axis of Foundation	XR = X-axis of Road	XS = X-axis of Sidewalk	XT = X-axis of Terrace	XU = X-axis of Utility	XV = X-axis of Vault	XW = X-axis of Wall	XX = X-axis of Excavation	XY = X-axis of Yard	XZ = X-axis of Zone	YA = Y-axis of Asphalt	YB = Y-axis of Building	YC = Y-axis of Concrete	YD = Y-axis of Driveway	YE = Y-axis of Easement	YF = Y-axis of Fence	YG = Y-axis of Gravel	YH = Y-axis of Hardscape	YI = Y-axis of Iron	YJ = Y-axis of Joint	YK = Y-axis of Kerf	YL = Y-axis of Ledge	YM = Y-axis of Masonry	YN = Y-axis of Niche	YO = Y-axis of Foundation	YP = Y-axis of Footing	YQ = Y-axis of Foundation	YR = Y-axis of Road	YS = Y-axis of Sidewalk	YT = Y-axis of Terrace	YU = Y-axis of Utility	YV = Y-axis of Vault	YW = Y-axis of Wall	YX = Y-axis of Excavation	YY = Y-axis of Yard	YZ = Y-axis of Zone	ZA = Z-axis of Asphalt	ZB = Z-axis of Building	ZC = Z-axis of Concrete	ZD = Z-axis of Driveway	ZE = Z-axis of Easement	ZF = Z-axis of Fence	ZG = Z-axis of Gravel	ZH = Z-axis of Hardscape	ZI = Z-axis of Iron	ZJ = Z-axis of Joint	ZK = Z-axis of Kerf	ZL = Z-axis of Ledge	ZM = Z-axis of Masonry	ZN = Z-axis of Niche	ZO = Z-axis of Foundation	ZP = Z-axis of Footing	ZQ = Z-axis of Foundation	ZR = Z-axis of Road	ZS = Z-axis of Sidewalk	ZT = Z-axis of Terrace	ZU = Z-axis of Utility	ZV = Z-axis of Vault	ZW = Z-axis of Wall	ZX = Z-axis of Excavation	ZY = Z-axis of Yard	ZZ = Z-axis of Zone
-----------------	---------------	--------------------	----------------------------------	-----------------------	-----------------------	--------------	-------------	-------------------	---------------------	------------	-----------	------------	------------	----------------------	-----------------------	-----------------------	-----------------------	-----------------------	--------------------	---------------------	------------------------	-------------------	--------------------	-------------------	--------------------	---------------	--------------------	-------------------	--------------------	---------------------	-------------------	-----------------------	----------------------	----------------------	--------------------	-------------------	-------------------------	-------------------	-------------------	----------------------	-----------------------	-----------------------	-----------------------	-----------------------	--------------------	---------------------	------------------------	-------------------	--------------------	-------------------	--------------------	----------------------	--------------------	-------------------------	----------------------	-------------------------	-------------------	-----------------------	----------------------	----------------------	--------------------	-------------------	-------------------------	-------------------	-------------------	-----------------------	------------------------	------------------------	------------------------	------------------------	---------------------	----------------------	-------------------------	--------------------	---------------------	--------------------	---------------------	-----------------------	---------------------	--------------------------	-----------------------	--------------------------	--------------------	------------------------	-----------------------	-----------------------	---------------------	--------------------	--------------------------	--------------------	--------------------	------------------------	-------------------------	-------------------------	-------------------------	-------------------------	----------------------	-----------------------	--------------------------	---------------------	----------------------	---------------------	----------------------	------------------------	----------------------	---------------------------	------------------------	---------------------------	---------------------	-------------------------	------------------------	------------------------	----------------------	---------------------	---------------------------	---------------------	---------------------	------------------------	-------------------------	-------------------------	-------------------------	-------------------------	----------------------	-----------------------	--------------------------	---------------------	----------------------	---------------------	----------------------	------------------------	----------------------	---------------------------	------------------------	---------------------------	---------------------	-------------------------	------------------------	------------------------	----------------------	---------------------	---------------------------	---------------------	---------------------	--------------------------	---------------------------	---------------------------	---------------------------	---------------------------	------------------------	-------------------------	----------------------------	-----------------------	------------------------	-----------------------	------------------------	--------------------------	------------------------	-----------------------------	--------------------------	-----------------------------	-----------------------	---------------------------	--------------------------	--------------------------	------------------------	-----------------------	-----------------------------	-----------------------	-----------------------	----------------------	-----------------------	-----------------------	-----------------------	-----------------------	--------------------	---------------------	------------------------	-------------------	--------------------	-------------------	--------------------	----------------------	--------------------	-------------------------	----------------------	-------------------------	-------------------	-----------------------	----------------------	----------------------	--------------------	-------------------	-------------------------	-------------------	-------------------	------------------------	-------------------------	-------------------------	-------------------------	-------------------------	----------------------	-----------------------	--------------------------	---------------------	----------------------	---------------------	----------------------	------------------------	----------------------	---------------------------	------------------------	---------------------------	---------------------	-------------------------	------------------------	------------------------	----------------------	---------------------	---------------------------	---------------------	---------------------	--------------------------	---------------------------	---------------------------	---------------------------	---------------------------	------------------------	-------------------------	----------------------------	-----------------------	------------------------	-----------------------	------------------------	--------------------------	------------------------	-----------------------------	--------------------------	-----------------------------	-----------------------	---------------------------	--------------------------	--------------------------	------------------------	-----------------------	-----------------------------	-----------------------	-----------------------	----------------------	-----------------------	-----------------------	-----------------------	-----------------------	--------------------	---------------------	------------------------	-------------------	--------------------	-------------------	--------------------	----------------------	--------------------	-------------------------	----------------------	-------------------------	-------------------	-----------------------	----------------------	----------------------	--------------------	-------------------	-------------------------	-------------------	-------------------	-----------------------------	------------------------------	------------------------------	------------------------------	------------------------------	---------------------------	----------------------------	-------------------------------	--------------------------	---------------------------	--------------------------	---------------------------	-----------------------------	---------------------------	--------------------------------	-----------------------------	--------------------------------	--------------------------	------------------------------	-----------------------------	-----------------------------	---------------------------	--------------------------	--------------------------------	--------------------------	--------------------------	--------------------------	---------------------------	---------------------------	---------------------------	---------------------------	------------------------	-------------------------	----------------------------	-----------------------	------------------------	-----------------------	------------------------	--------------------------	------------------------	-----------------------------	--------------------------	-----------------------------	-----------------------	---------------------------	--------------------------	--------------------------	------------------------	-----------------------	-----------------------------	-----------------------	-----------------------	--------------------------	---------------------------	---------------------------	---------------------------	---------------------------	------------------------	-------------------------	----------------------------	-----------------------	------------------------	-----------------------	------------------------	--------------------------	------------------------	-----------------------------	--------------------------	-----------------------------	-----------------------	---------------------------	--------------------------	--------------------------	------------------------	-----------------------	-----------------------------	-----------------------	-----------------------	------------------------	-------------------------	-------------------------	-------------------------	-------------------------	----------------------	-----------------------	--------------------------	---------------------	----------------------	---------------------	----------------------	------------------------	----------------------	---------------------------	------------------------	---------------------------	---------------------	-------------------------	------------------------	------------------------	----------------------	---------------------	---------------------------	---------------------	---------------------	-----------------------	------------------------	------------------------	------------------------	------------------------	---------------------	----------------------	-------------------------	--------------------	---------------------	--------------------	---------------------	-----------------------	---------------------	--------------------------	-----------------------	--------------------------	--------------------	------------------------	-----------------------	-----------------------	---------------------	--------------------	--------------------------	--------------------	--------------------	---------------------------	----------------------------	----------------------------	----------------------------	----------------------------	-------------------------	--------------------------	-----------------------------	------------------------	-------------------------	------------------------	-------------------------	---------------------------	-------------------------	------------------------------	---------------------------	------------------------------	------------------------	----------------------------	---------------------------	---------------------------	-------------------------	------------------------	------------------------------	------------------------	------------------------	----------------------	-----------------------	-----------------------	-----------------------	-----------------------	--------------------	---------------------	------------------------	-------------------	--------------------	-------------------	--------------------	----------------------	--------------------	-------------------------	----------------------	-------------------------	-------------------	-----------------------	----------------------	----------------------	--------------------	-------------------	-------------------------	-------------------	-------------------	------------------------	-------------------------	-------------------------	-------------------------	-------------------------	----------------------	-----------------------	--------------------------	---------------------	----------------------	---------------------	----------------------	------------------------	----------------------	---------------------------	------------------------	---------------------------	---------------------	-------------------------	------------------------	------------------------	----------------------	---------------------	---------------------------	---------------------	---------------------	-----------------------	------------------------	------------------------	------------------------	------------------------	---------------------	----------------------	-------------------------	--------------------	---------------------	--------------------	---------------------	-----------------------	---------------------	--------------------------	-----------------------	--------------------------	--------------------	------------------------	-----------------------	-----------------------	---------------------	--------------------	--------------------------	--------------------	--------------------	------------------------	-------------------------	-------------------------	-------------------------	-------------------------	----------------------	-----------------------	--------------------------	---------------------	----------------------	---------------------	----------------------	------------------------	----------------------	---------------------------	------------------------	---------------------------	---------------------	-------------------------	------------------------	------------------------	----------------------	---------------------	---------------------------	---------------------	---------------------	------------------------	-------------------------	-------------------------	-------------------------	-------------------------	----------------------	-----------------------	--------------------------	---------------------	----------------------	---------------------	----------------------	------------------------	----------------------	---------------------------	------------------------	---------------------------	---------------------	-------------------------	------------------------	------------------------	----------------------	---------------------	---------------------------	---------------------	---------------------	------------------------	-------------------------	-------------------------	-------------------------	-------------------------	----------------------	-----------------------	--------------------------	---------------------	----------------------	---------------------	----------------------	------------------------	----------------------	---------------------------	------------------------	---------------------------	---------------------	-------------------------	------------------------	------------------------	----------------------	---------------------	---------------------------	---------------------	---------------------

### DRAWING / CLIENT INFORMATION

**John F. Garcia**  
1718 north Edgewood Avenue  
Jacksonville, Florida 32251

Survey Date: 11/23/2019  
Scale: 1" = 20 Feet  
Drawn By: tm  
Field Book/Page: #12119.1

Additional Information/Certifications

### ALTA LAND SURVEYING, INC

Professional Surveying & Mapping Services  
Residential - Commercial - Environmental - Development  
3226 RIVER ROAD  
GREEN COVE SPRINGS 32043  
LICENSED SURVEY BUSINESS # 8311

TIMOTHY L. BLACKMON, PSM  
MONTEAGUE, FLORIDA  
SURVEYING & MAPPING, INC.

C.H. WRIGHT, III, PSM  
ORANGE, FLORIDA  
C/O SURVEYING & MAPPING, INC.