
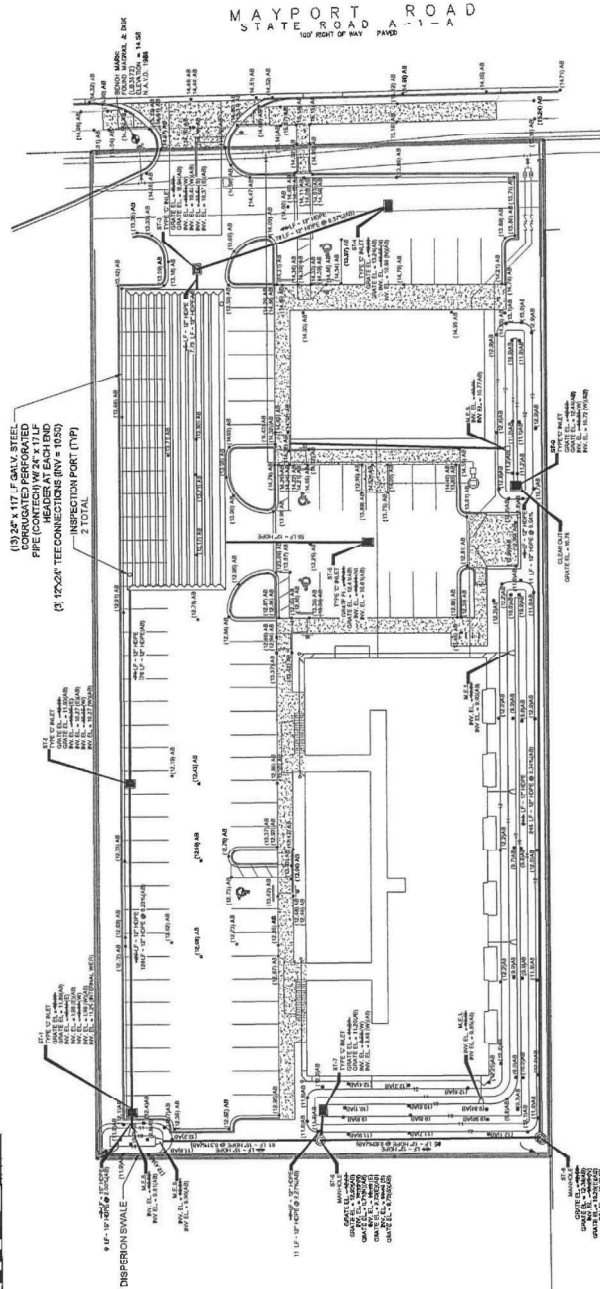


PAVING AND DRAINAGE
AS-BUILT
 MAYPORT APARTMENTS

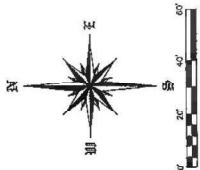

SURVEYORS STATEMENT
 INFORMATION PROVIDED BY:
 KAYCAR CONSULTING, LLC
 1305 SOUTH ST. #100
 JACKSONVILLE, FL 32231
 PHONE: 904.242.2121
 I HEREBY CERTIFY THAT THE
 INFORMATION PROVIDED IS TRUE
 AND CORRECT TO THE BEST OF
 MY KNOWLEDGE AND BELIEF.
 SIGNATURE: [Signature] SURVEYOR
 DATE: [Date]

CONTRACTORS STATEMENT
 INFORMATION PROVIDED BY:
 WHITESTONE DEVELOPMENT GROUP
 205 W. 1ST ST.
 JACKSONVILLE, FL 32202
 PHONE: 904.242.2121
 I HEREBY CERTIFY THAT THE
 INFORMATION PROVIDED IS TRUE
 AND CORRECT TO THE BEST OF
 MY KNOWLEDGE AND BELIEF.
 SIGNATURE: [Signature] CONTRACTOR
 DATE: [Date]

Legend:

- PAVED AREA
- UNPAVED AREA
- CURB & GUTTER
- DRAINAGE
- ELEVATIONS
- SPOTS
- DIMENSIONS

Scale: 1" = 30'

Sheet: 1 of 2

Project: AS-BUILT PAVING AND DRAINAGE - MAYPORT APARTMENTS

Prepared by: KAYCAR CONSULTING, LLC
 DATE: 7/11/23

2152 MAYPORT RD.
 7/11/23
 TRACKING # 5091
 EXHIBIT E