


18 - 922757

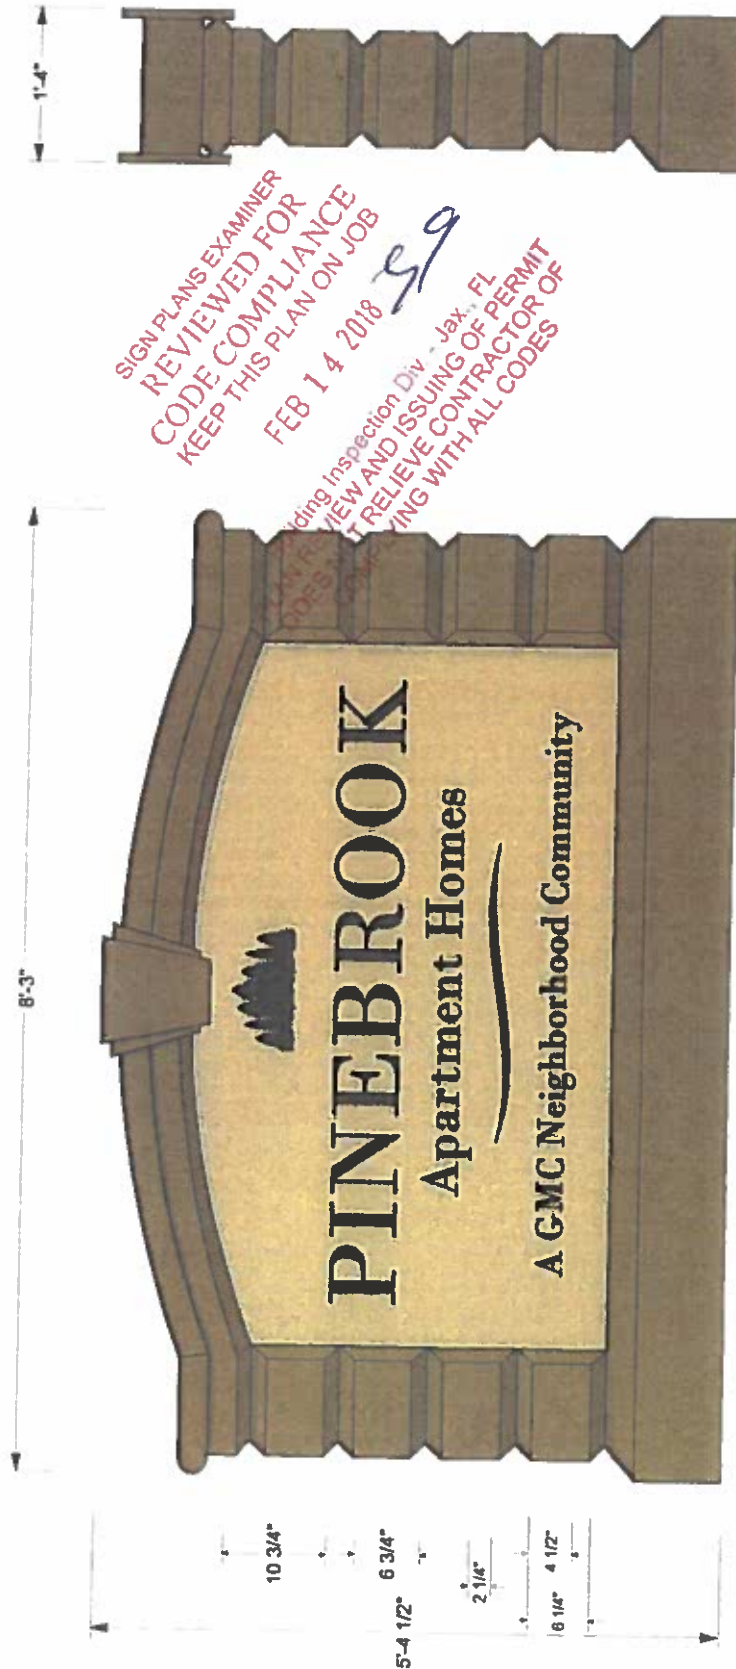

SIGN PLANS EXAMINER  
 REVIEWED FOR  
 CODE COMPLIANCE  
 KEEP THIS PLAN ON JOB  
 FEB 14 2018 *59*  
 Building Inspection Div - Jax, FL  
 REVIEW AND ISSUING OF PERMIT  
 AT RELIEVE CONTRACTOR OF  
 ANY VIOLATIONS BY VERIFYING WITH ALL CODES

FRONT & BACK ELEVATIONS

SIDE ELEVATION

FABRICATE AND INSTALL (1) DOUBLE SIDED NON-ILLUMINATED SYNTHETIC STUCCO MONUMENT SIGN WITH PAINTED FINISH. LOGO AND LETTERS TO BE 1/4 THICK ROUTED ALUMINUM WITH PAINTED FINISH AND STUD MOUNTED.

Scale 1"=1'-0"

Color key:  
 PINEBROOK SIGN  
 PINEBROOK BORDER  
 BLACK LETTERS

**harbinger.**  
 sign of the future  
 3309 Shuf Road, Jacksonville, FL 32257 - 944.388.4881  
 2201 Ohio Dr. Palm, FL 32257 - 877.367.5428

GMC Property Management  
 4821 Atlantic Blvd  
 Jacksonville, FL 32207

GMC 100-02  
 F:\Customers\GMC Property Management\DESIGN\GMC-100-02

THIS DESIGN IS FOR THE SOLE PURPOSE OF ILLUSTRATION & CONCEPT DESIGN. THIS FILE IS NOT TO BE USED FOR PRODUCTION AND/OR FABRICATION. THIS DESIGN IS THE SOLE PROPERTY OF HARBINGER AND MAY NOT BE USED OR REPRODUCED IN ANY FORM WITHOUT THE EXPRESS WRITTEN PERMISSION OF HARBINGER.

Salesperson: RR    PM: cb    Designer: rk    Page: 1



THIS DESIGN IS FOR THE SOLE PURPOSE OF ILLUSTRATION & CONCEPT DESIGN. THIS FILE IS NOT TO BE USED FOR PRODUCTION AND/OR FABRICATION. THIS DESIGN IS THE SOLE PROPERTY OF HARBINGER AND MAY NOT BE USED OR REPRODUCED IN ANY FORM WITHOUT THE EXPRESS WRITTEN PERMISSION OF HARBINGER.

NOTE: All work performed within an easement or a Public Right-of-Way requires a separate permit by the Division of Development Services. Provide a min. 3' clearance from the edge of driveways to any structure such as inlets, transformers, poles, etc., in the right-of-way easement.


2/11/18

11. DIM  
C915

CHORD = S 22°49'18" E 331.97' (FIELD)  
 RADIUS = 1104.94' ARC = 331.84'  
 $\Delta = 17'16'23"$  = 333.11'

ELEMENT PAGE 732

E

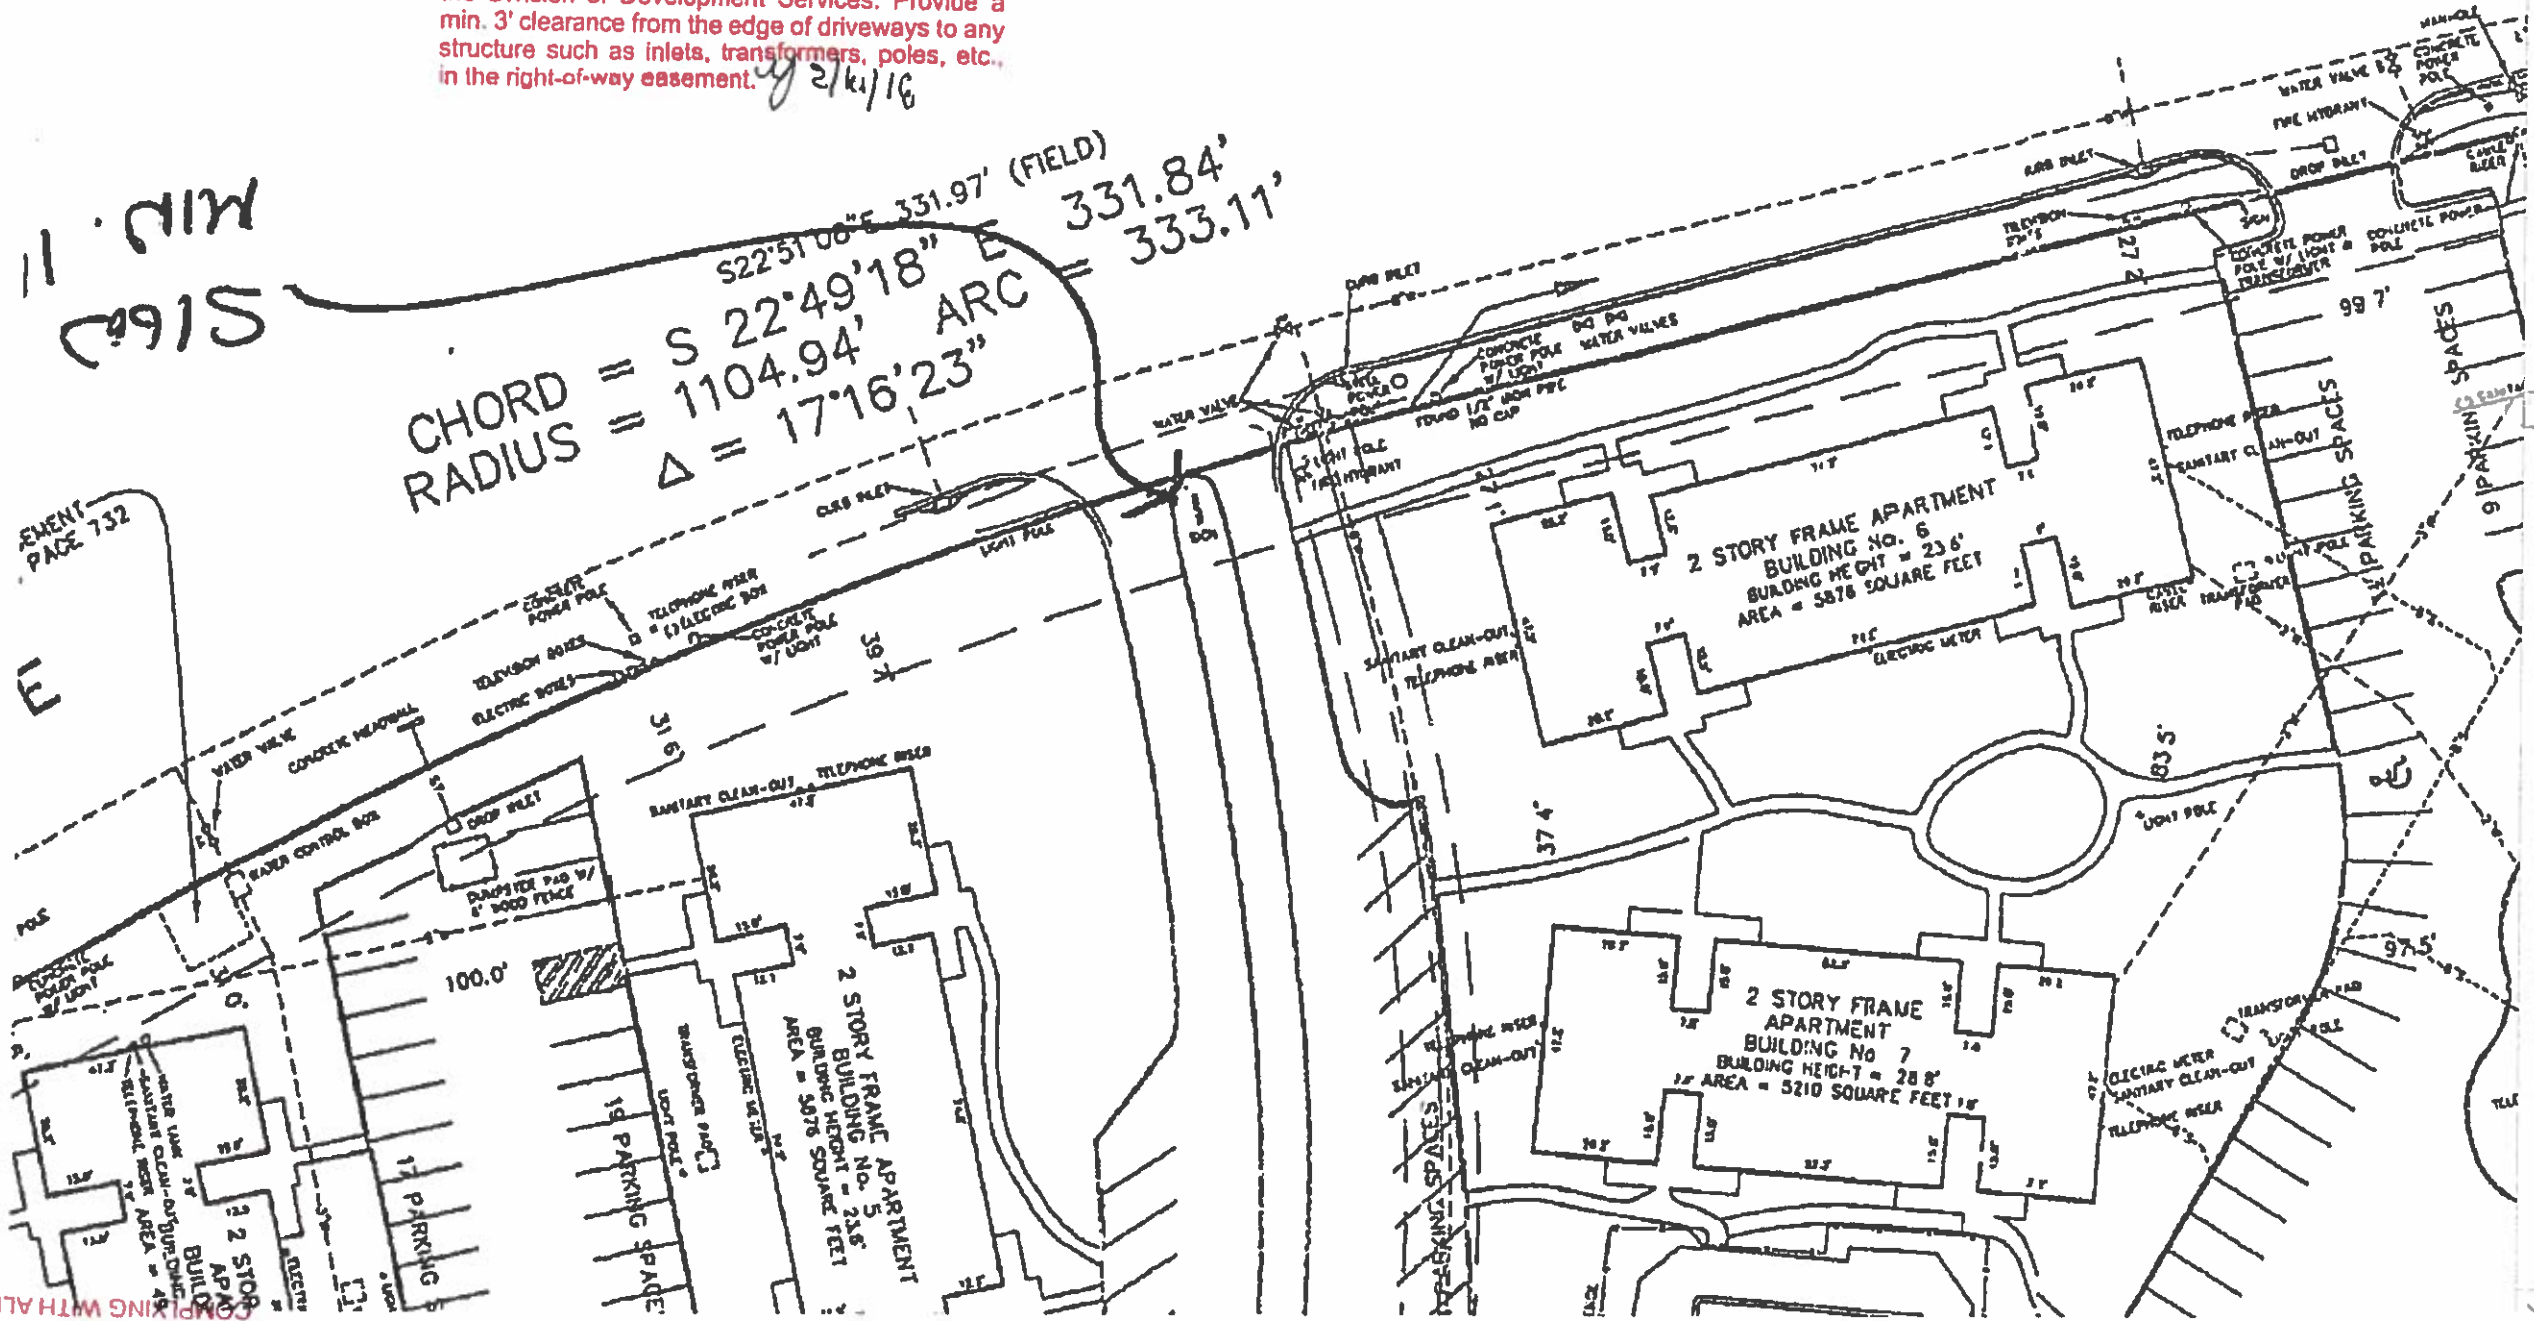


Building Inspection Div - Jax, FL  
 PLAN REVIEW AND ISSUING OF PERMIT  
 DOES NOT RELIEVE CONTRACTOR OF  
 COMPLIANCE WITH ALL CODES

FEB 14 2018

SIGN PLANS EXAMINER  
 REVIEWED FOR  
 CODE COMPLIANCE  
 KEEP THIS PLAN ON JOB

18-922757

34'  
7'16"23"

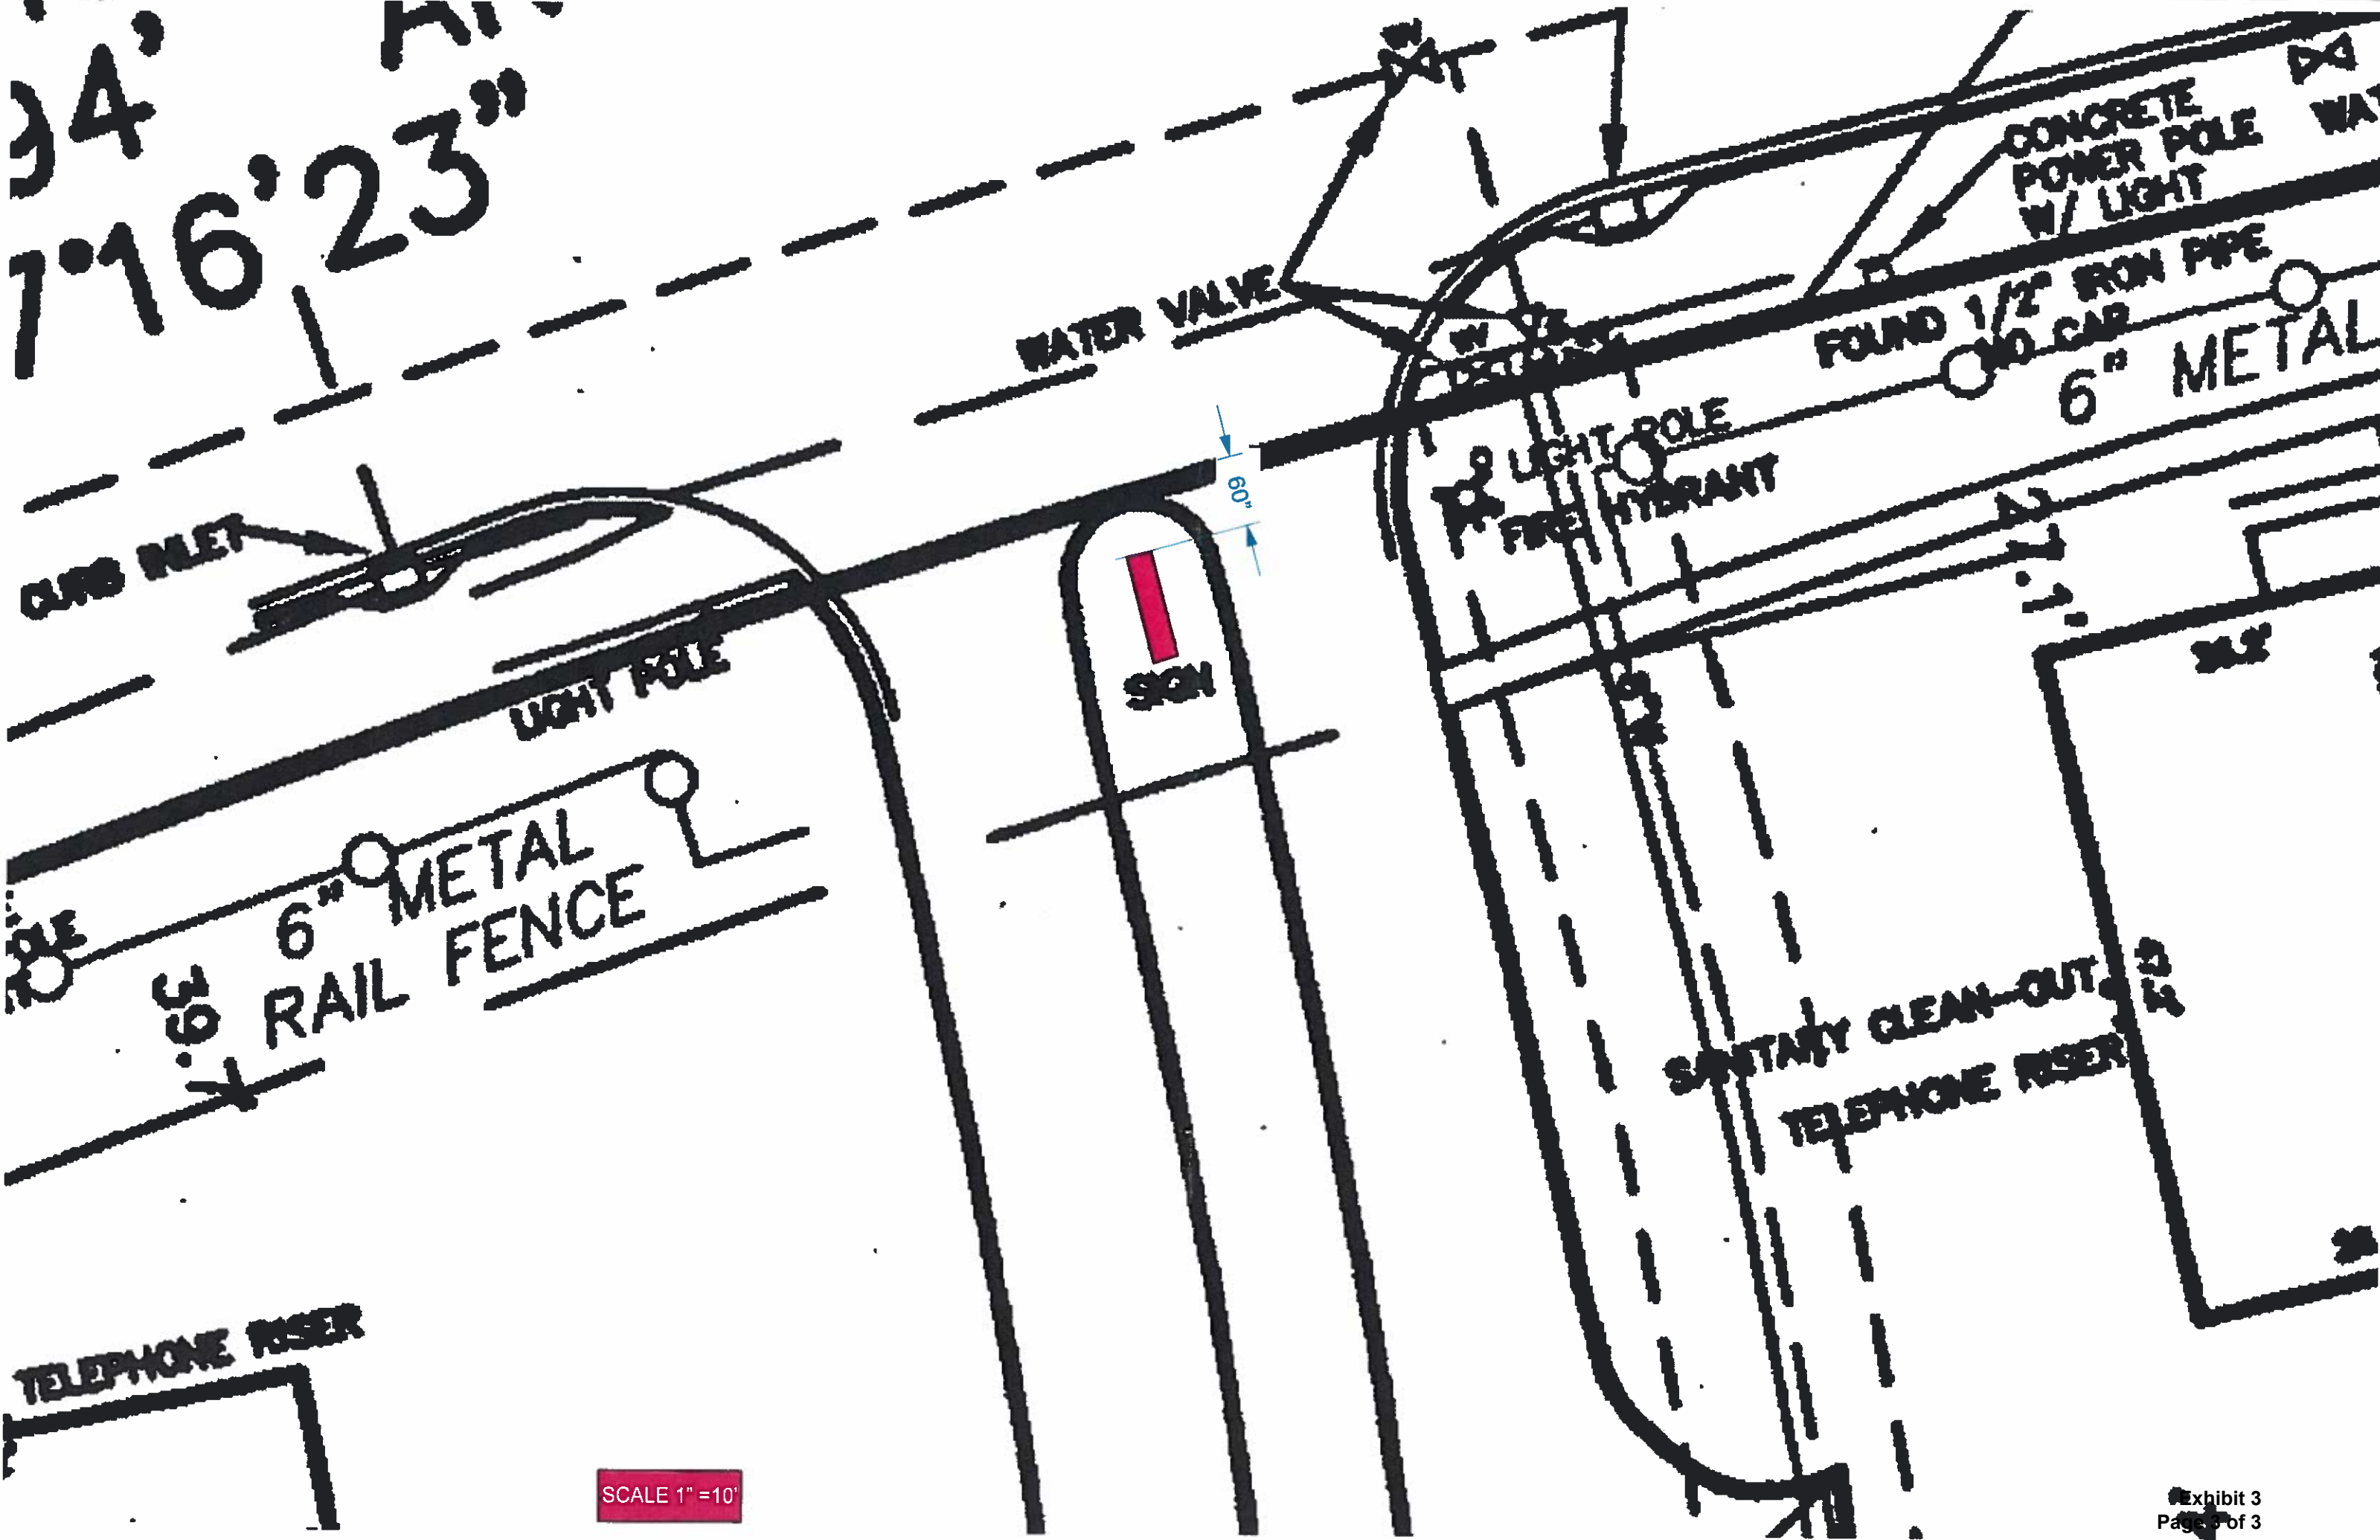

SCALE 1" = 10'